
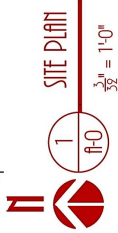


# Appendix A-3.1

**General Notes:**  
 -Drawings are property of Brad Dayton Drafting & Design (BDDDD). No reproduction of drawings or drawings without the written permission from BDDDD.  
 -BDDDD assumes no liability for errors or omissions from the use of these drawings.  
 -All measurements to be verified by Contractor on-site.  
 -Drawings are to be printed on 11"x17" paper to be to proper scale as shown

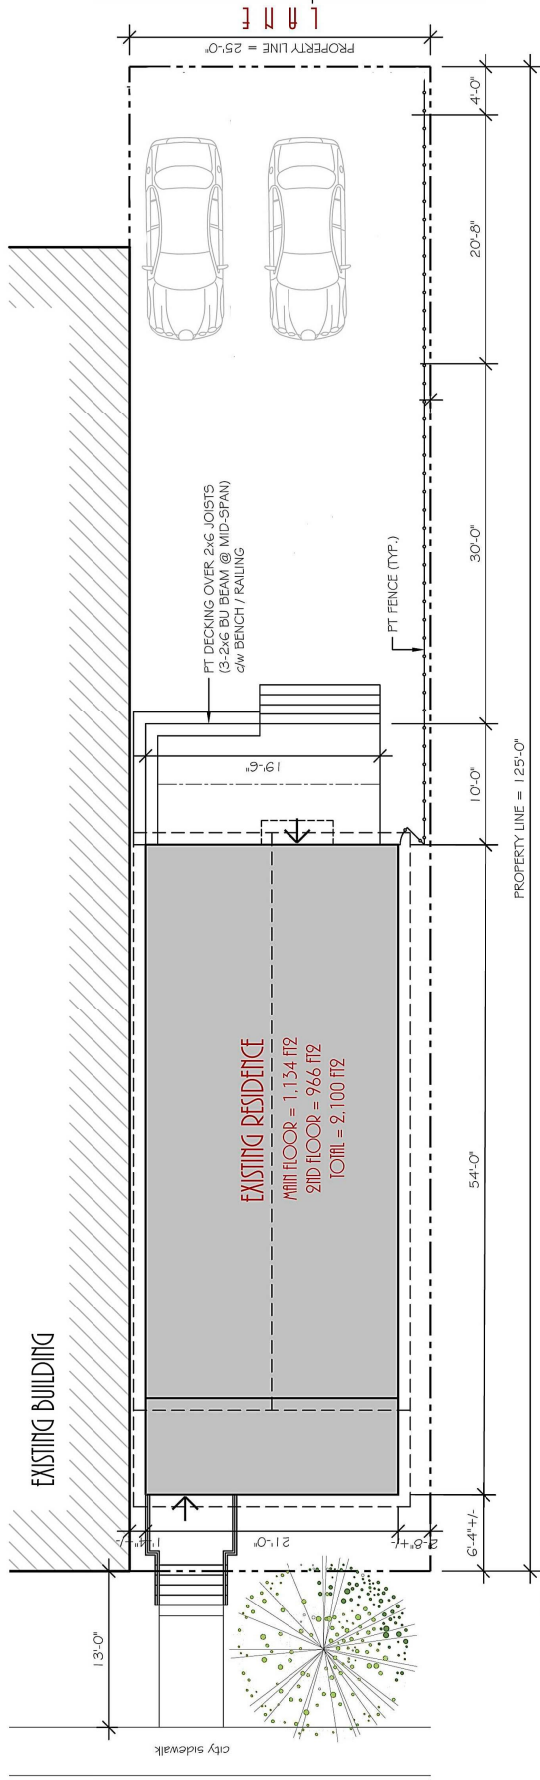

Series	170303   ISSUED FOR ENG
<b>PRELIMINARY NOT FOR CONSTRUCTION</b>	
Project Title	MacDonald Residence 1817 Halifax Street Regina, SK
Drawing Title	Site Plan -AS-BUILT