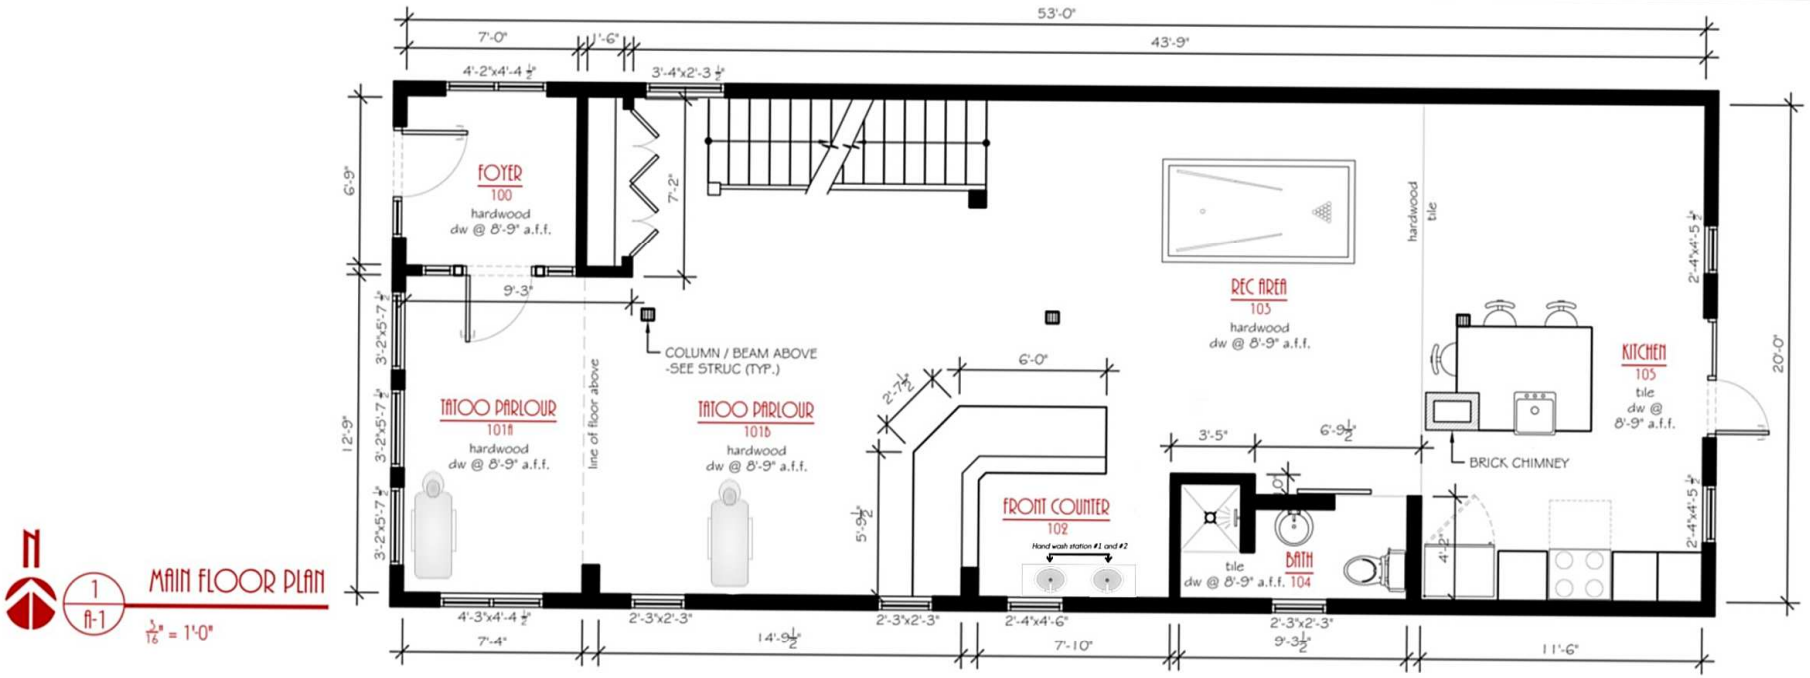

N

1
A-1
MAIN FLOOR PLAN

1/16" = 1'-0"

BASEMENT

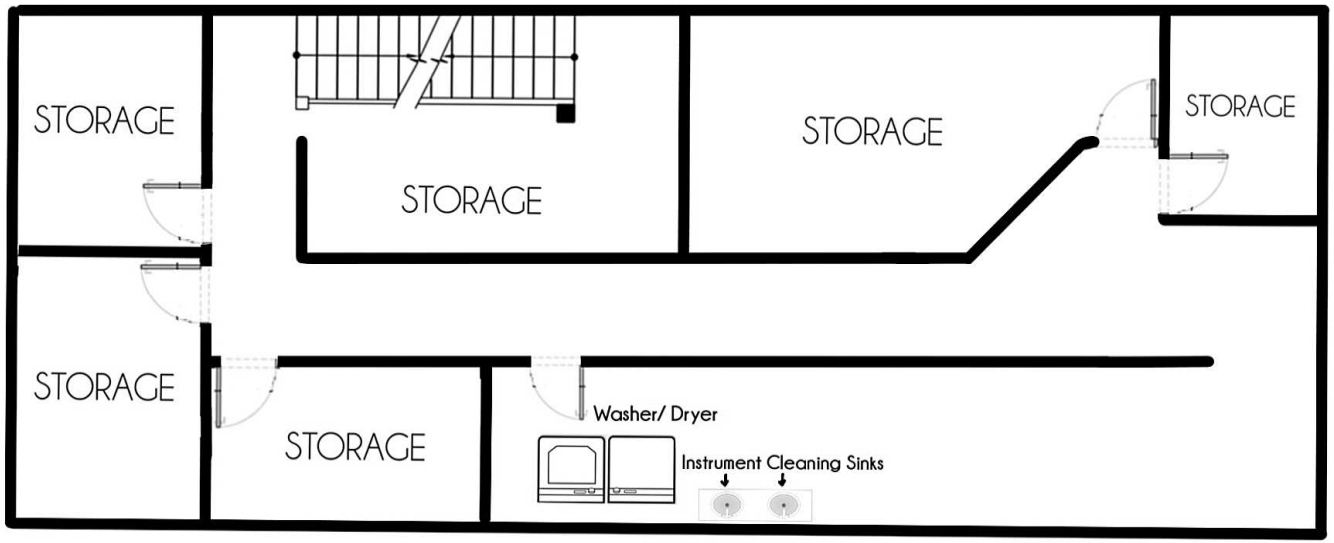

Architectural Draftsperson
BRAD DAYTON
DRAFTING & DESIGN
RESIDENTIAL TECHNOLOGIST
TEL: 306-520-3216
EMAIL: BDAYTON@LIVE.CA

General Notes:
-Drawings are property of Brad Dayton Drafting & Design. (BDD&D) No reproduction of these drawings is allowed without the written permission from BDD&D.
-BDD&D assumes no liability for any errors or omissions from the use of these drawings
-All measurements to be verified by Contractor on-site
-Do not scale drawings. Work from given dimensions
-Drawings are to be printed on 11"x17" paper to be to proper scale as shown

170410	ISSUED FOR CONST
170303	ISSUED FOR ENG

Seals

ISSUED FOR CONSTRUCTION

Project Title
MacDonald Residence
1817 Halifax Street
Regina, SK

Drawing Title
Main Floor Plans
-As-built

A-1